


FLOOR PLAN
SCALE: 1/16" = 1'-0"

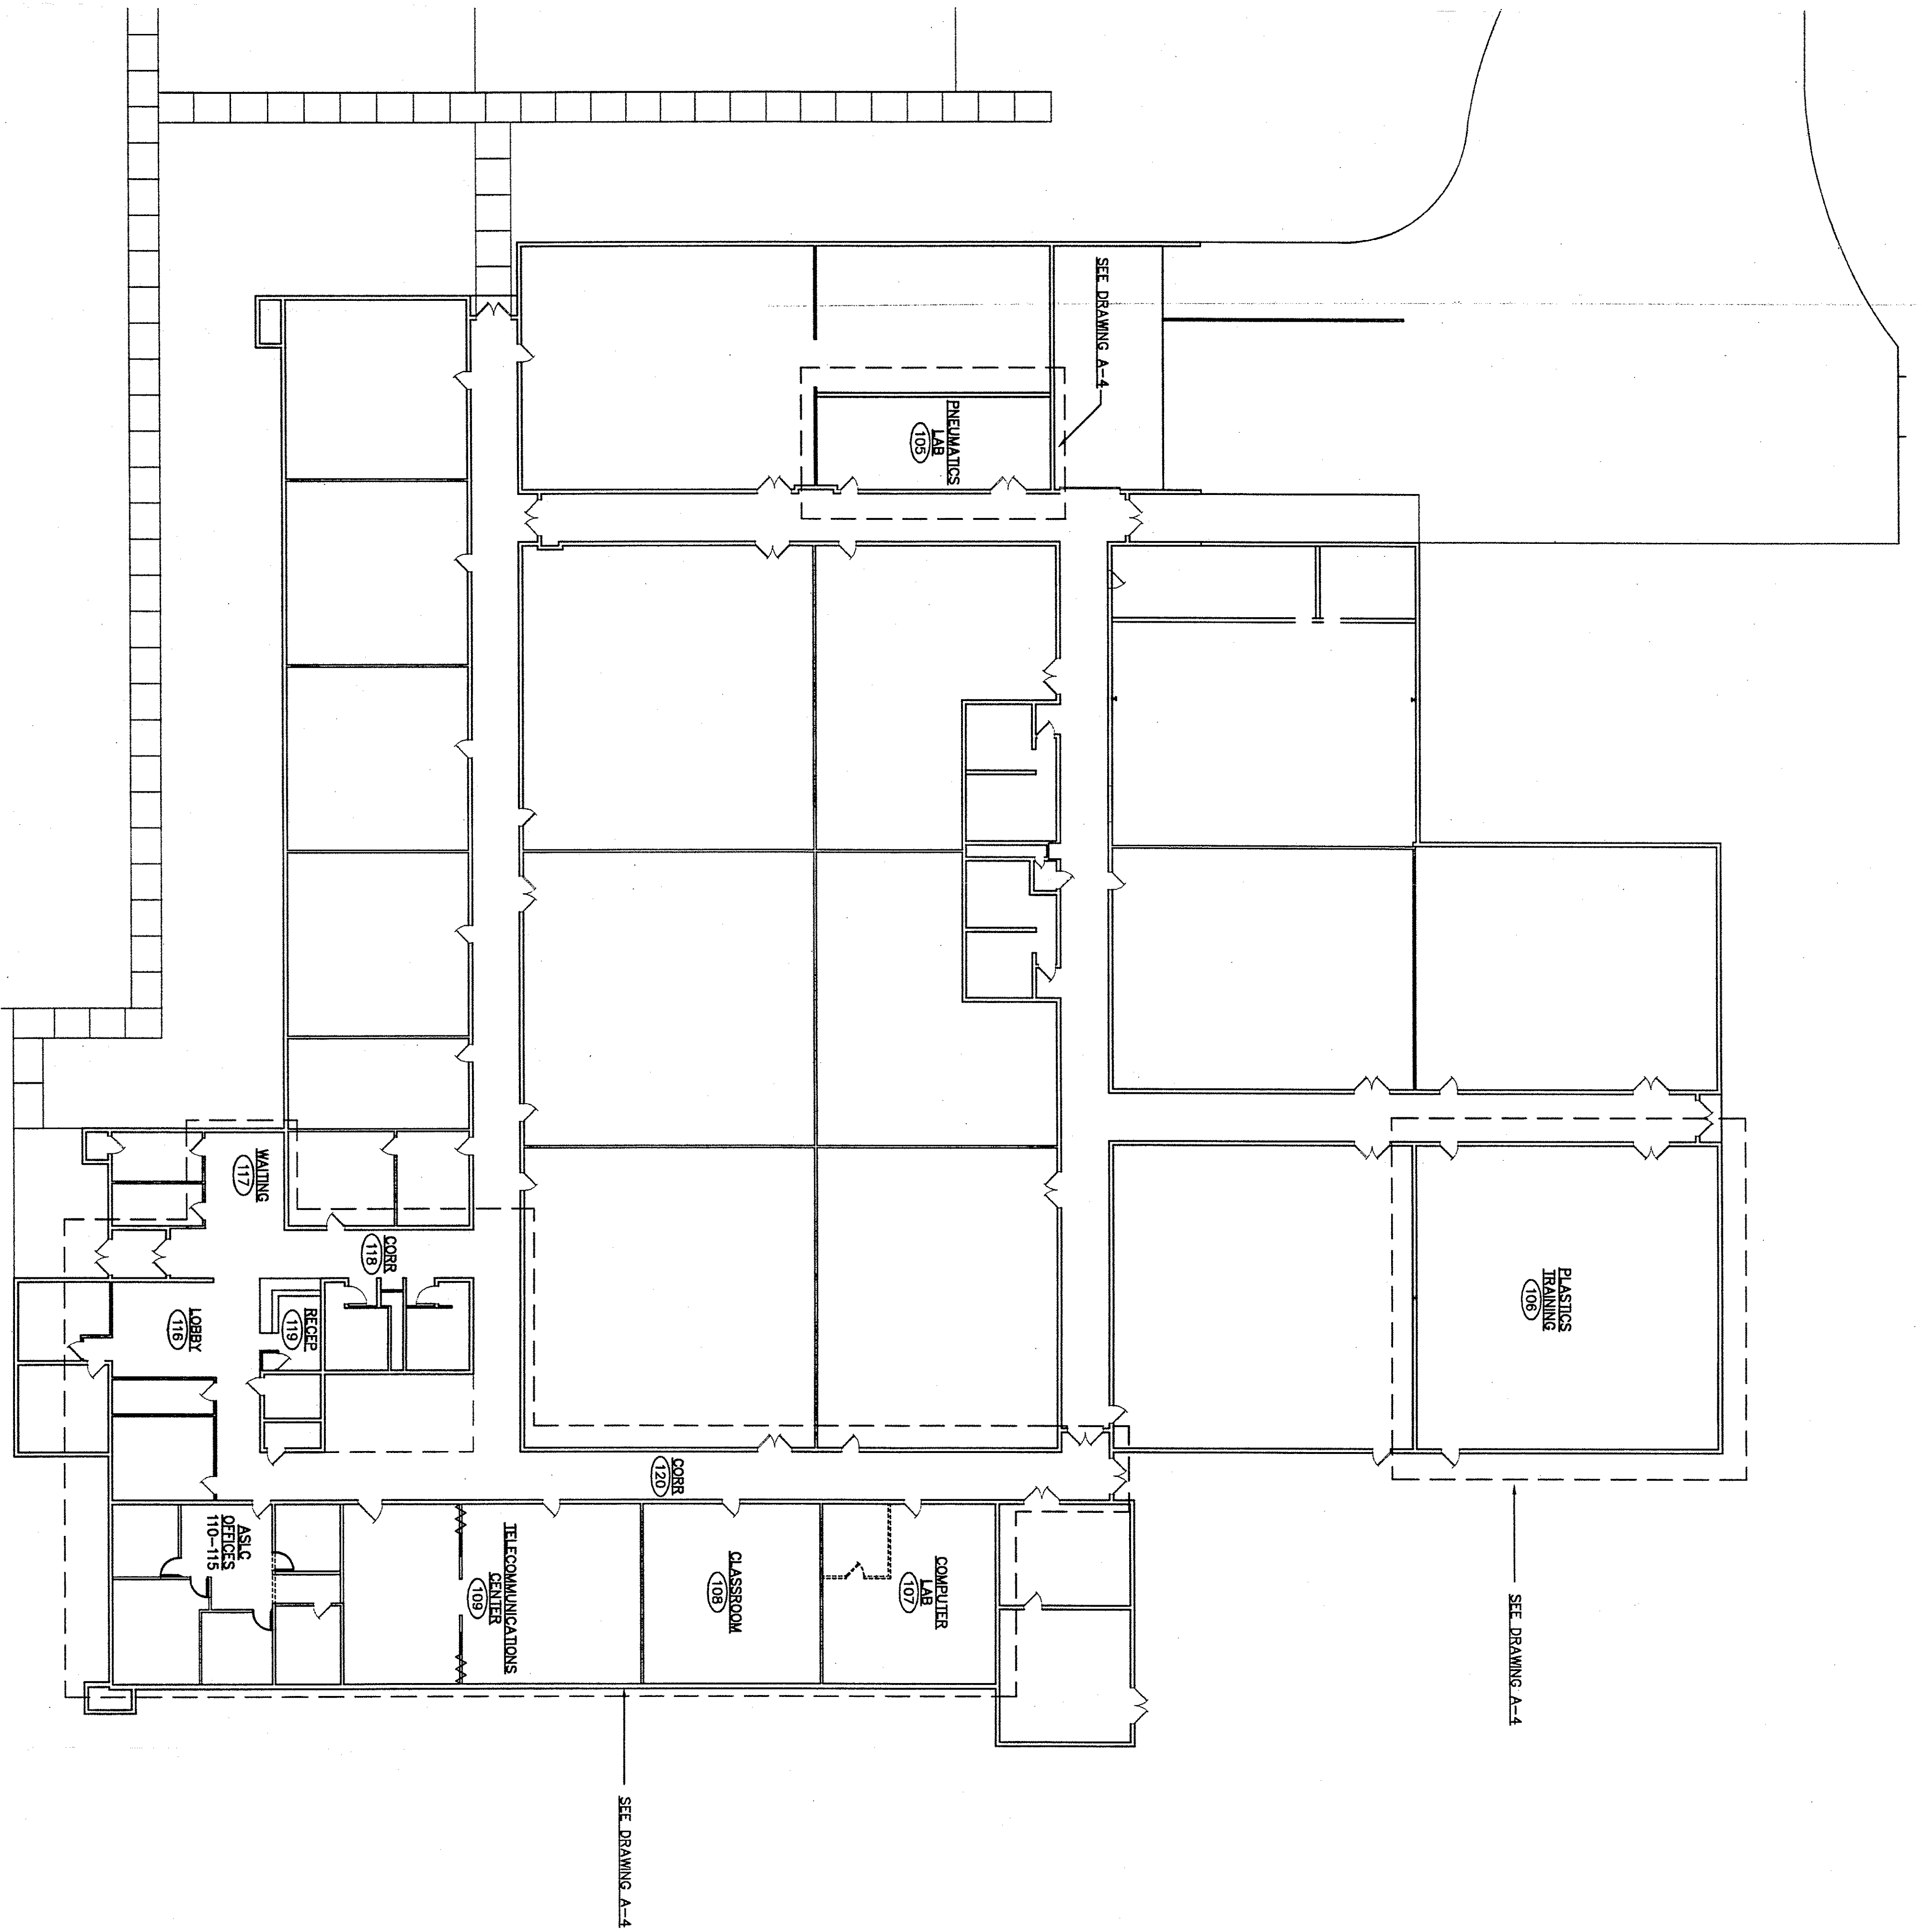

TITLE
OVERALL FLOOR PLAN
PROJECT
CYBER CENTER
ADVANCED SKILLS LEARNING CENTER
YORK PA

SCALE
1/16" = 1'-0"
DRAWN BY
CHECKED BY
DATE
9/27/00
CONTACT
REVISIONS
REV
REV

NuTec Design Associates, Inc.
architects · engineers · surveyors
3687 Concord Road 178 Thomas Johnson Drive
York, PA 17402 Suite 204
717-751-0300 Frederick, MD 21702
301-682-9080

jdb ENGINEERING, INC.
CONSULTING ENGINEERS
3687 Concord Rd. 120 Cockeysville Rd #101
York, PA 17402 Hunt Valley, MD 21030
717-757-5602 410-771-3433
Job No. 400028.00

REVISIONS		
0	9/27/00	ISSUED FOR BIDDING
	8/22/02	RECORD DRAWINGS

A-3
0
Copyright © 2002