COPYRIGHT © 2007 DARRELL F. SUNDAY ASSOCIATES, INC.

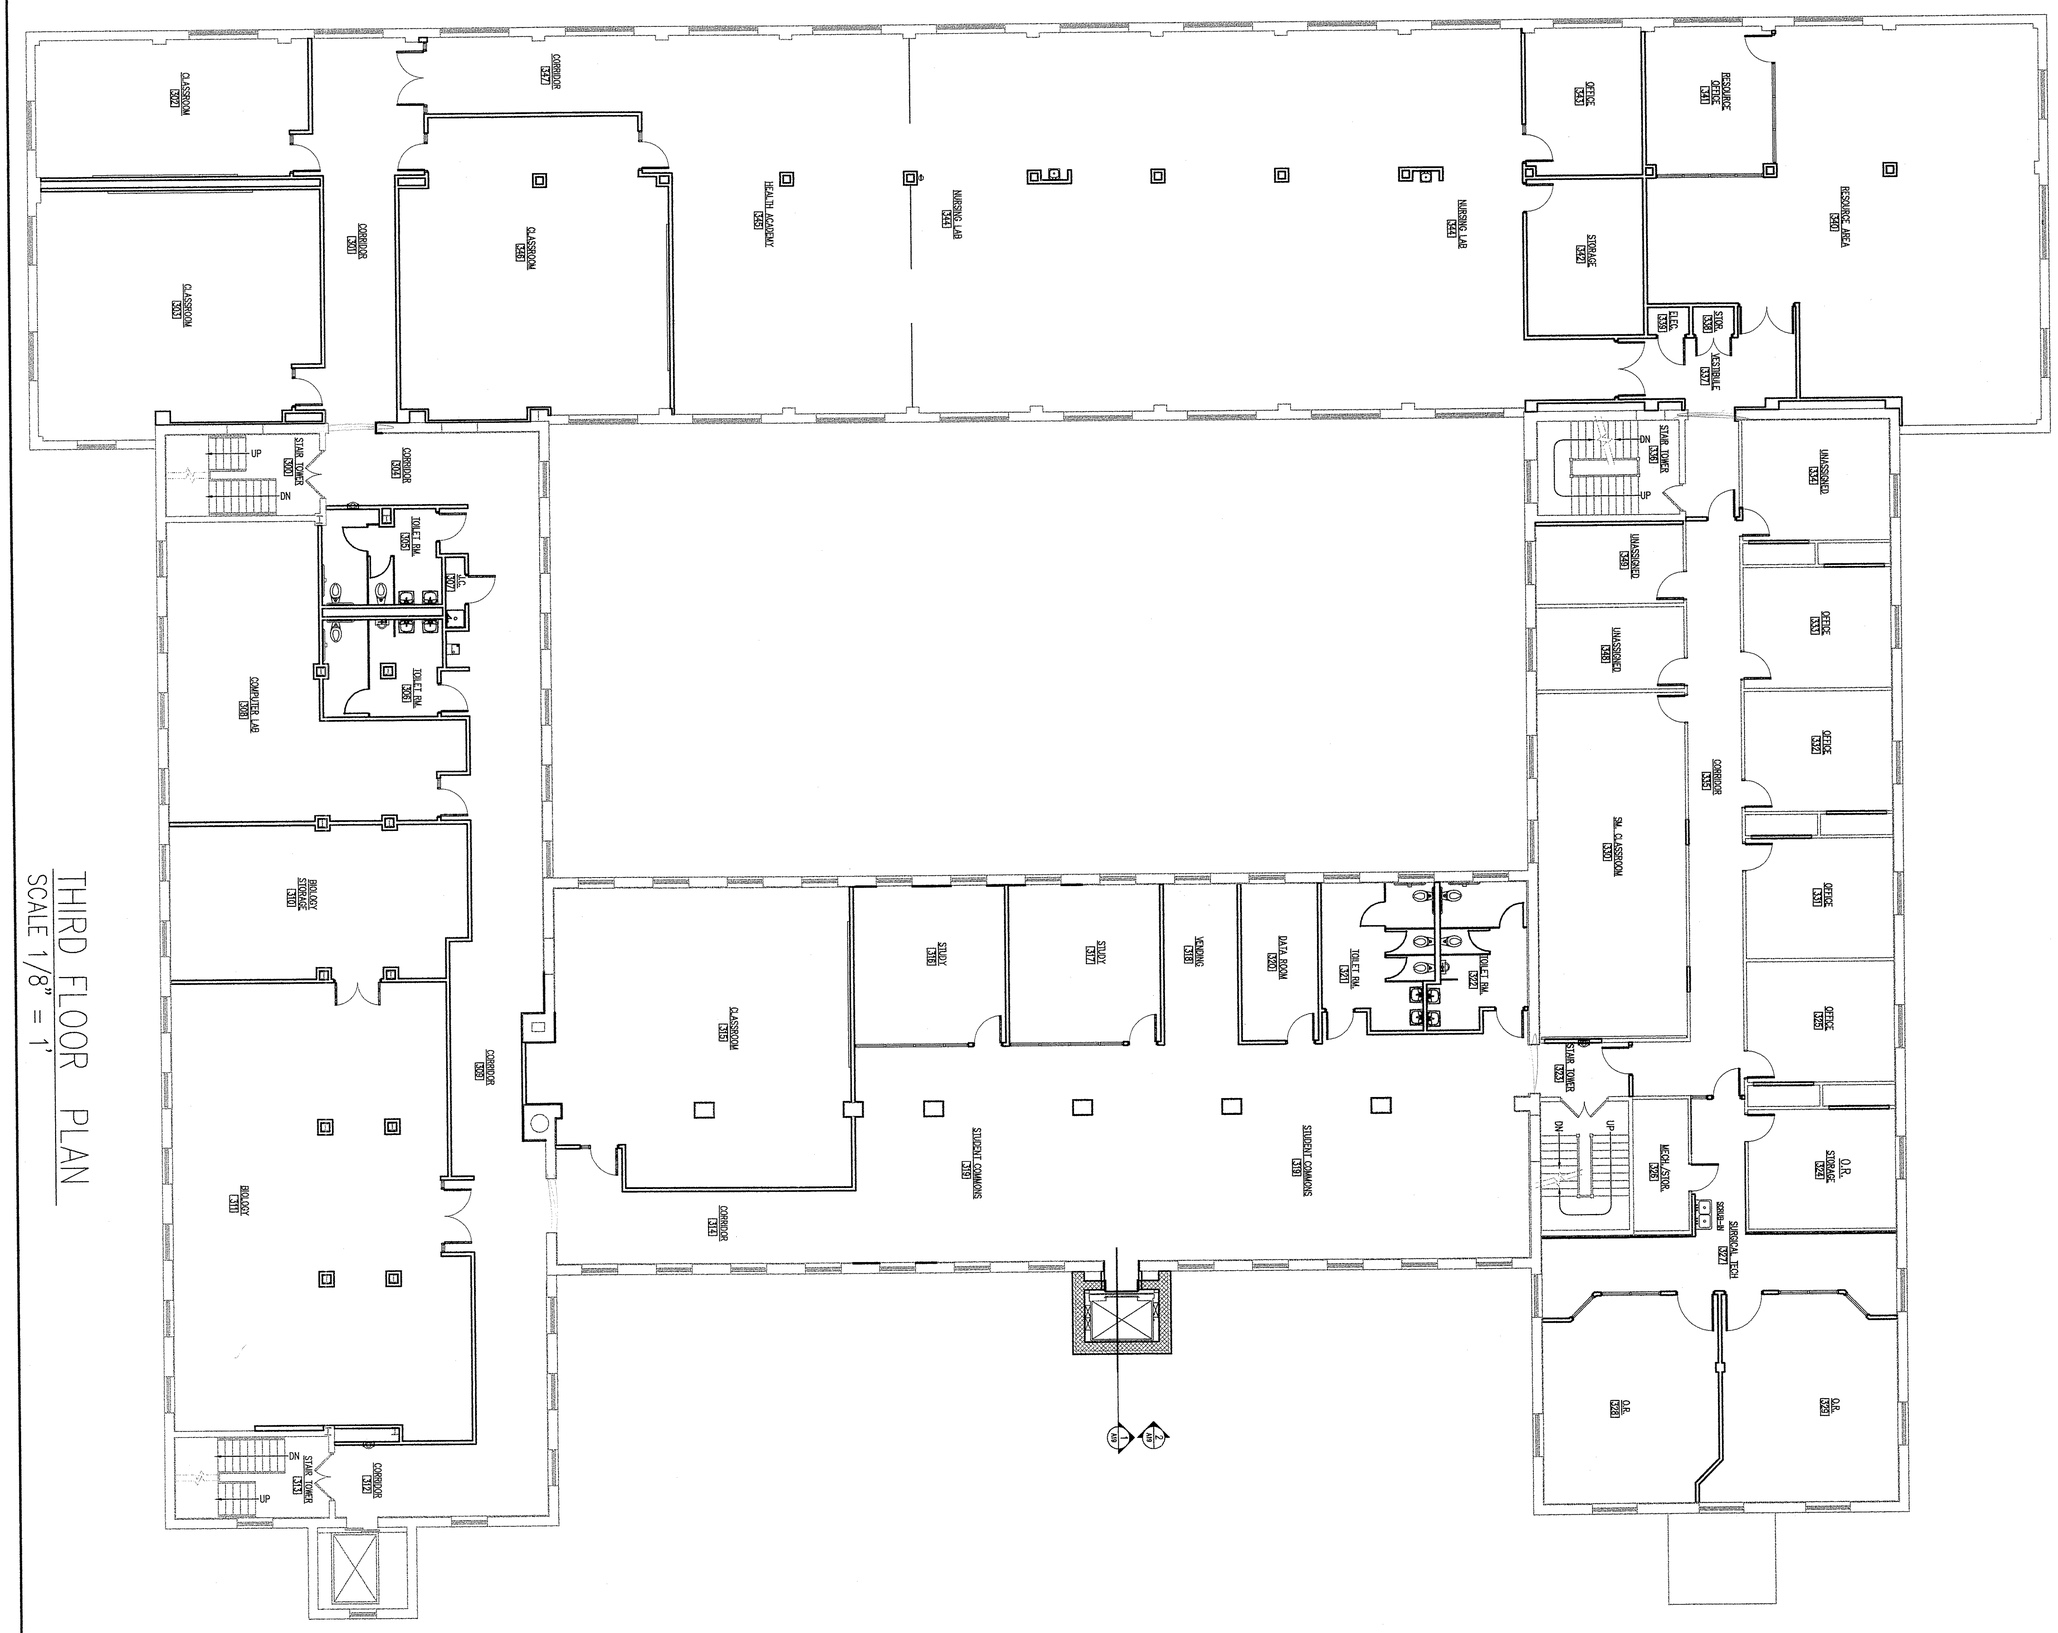

THIRD FLOOR PLAN
SCALE 1/8" = 1'

THREE PENN CENTER
for
DALEY AND MORRIS PARTNERSHIP
NORTH THIRD STREET
DAUPHIN COUNTY, HARRISBURG, PENNSYLVANIA

Darrell F. Sunday Associates, Inc.
Architecture, Planning & Design
One Penn Center, Fifth Floor
2601 North 3rd Street P.O. Box 5086 Harrisburg, PA 17110
tel.: 717-232-2270 fax: 717-232-2747

EASTERN PCM, LLC
PROGRAM AND CONSTRUCTION MANAGEMENT ... PUTTING THE PIECES TOGETHER

DRAWING TITLE
THIRD FLOOR PLAN
RECORD DRAWING 2-19-2004

DATE	06/04/2007
REVISION	
DRAWN BY	JMP
PROJECT NUMBER	07-1038
DRAWING NUMBER	A-1.02