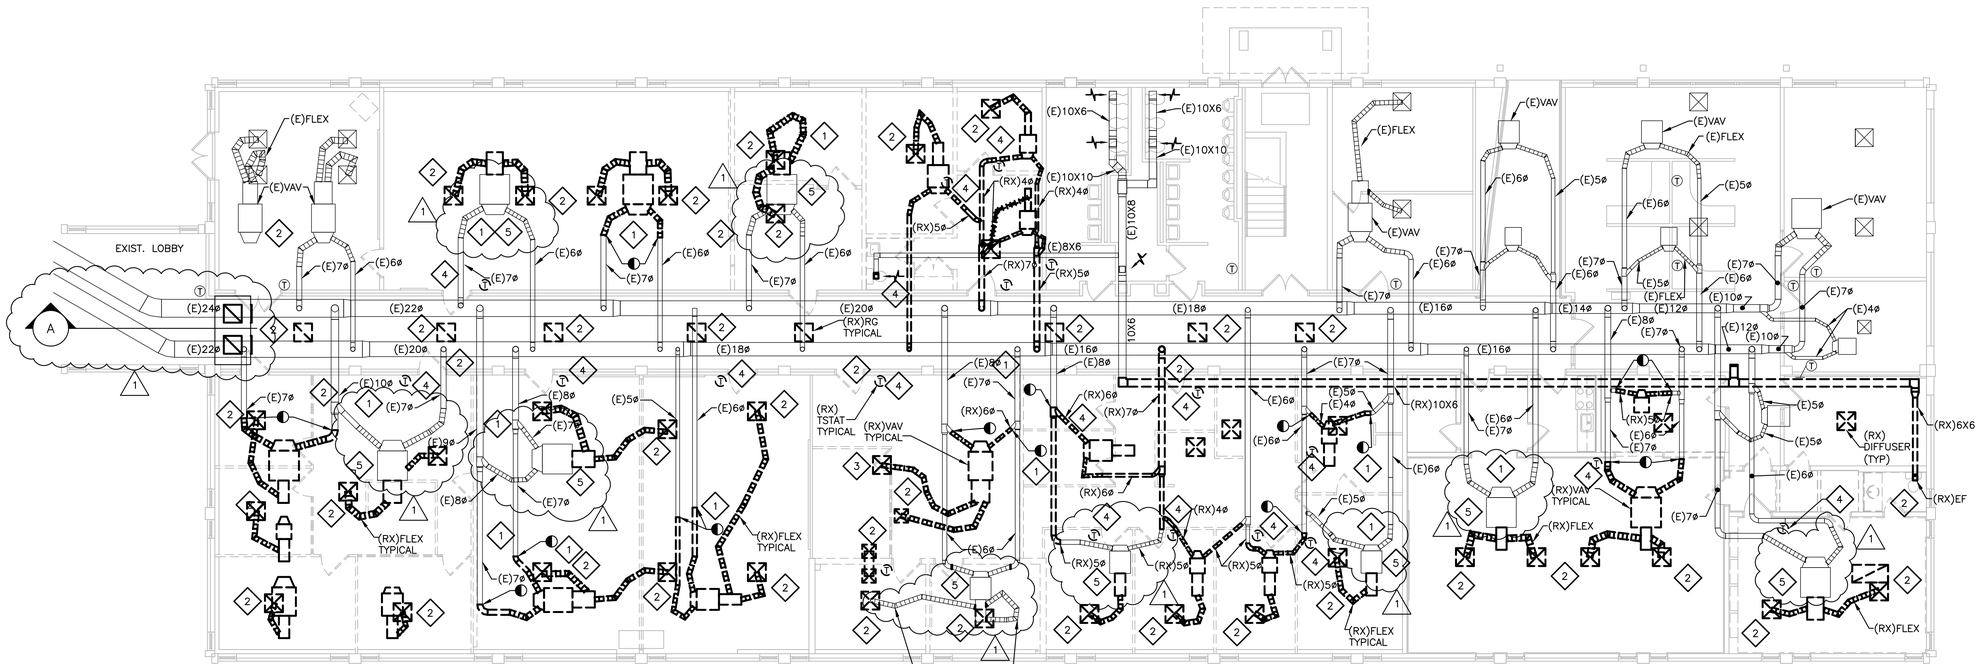

PARTIAL FIRST FLOOR PLAN – DEMOLITION

SCALE: 1/8" = 1'–0"

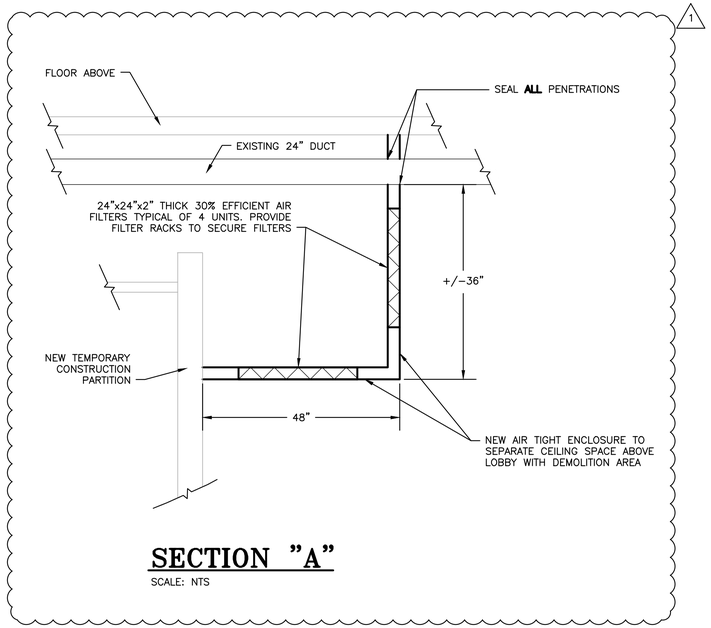

SECTION "A"

SCALE: NTS

SYMBOLS, NOTES & ABBREVIATIONS:

- EXISTING VAV BOX TO BE REMOVED
- EXISTING VAV TO REMAIN
- DARK DASHED LINES INDICATE ITEMS TO BE REMOVED
- STOPPING POINT OF DEMOLITION SEAL DUCT AIR TIGHT (1)
- SUPPLY AIR DUCT (UP,DOWN)
- EXHAUST AIR DUCT (UP,DOWN)
- RETURN AIR DUCT (UP,DOWN)
- 90° BEND WITH TURNING VANES
- SUPPLY AIR DIFFUSER, SD TO BE REMOVED.
- EXHAUST AIR GRILLE, EG TO BE REMOVED.
- RETURN AIR GRILLE, RG TO BE REMOVED.
- THERMOSTAT:

DIFF	DIFFUSER
(E)	EXISTING TO REMAIN
RX	REMOVE EXISTING

DRAWING NOTES:

1. REMOVE EXISTING SUPPLY AIR DUCT BRANCH TO POINT INDICATED. CAP AND SEAL UNUSED CONNECTION AT MAIN SUPPLY TRUNK DUCT.
2. REMOVE EXISTING SUPPLY AIR DEVICE AND DUCT BRANCH CONNECTION. REPLACE CEILING TILES AS REQUIRED. (1)
3. REMOVE EXISTING RETURN AIR DEVICE. REPLACE CEILING TILES AS REQUIRED. (1) (1)
4. REMOVE EXISTING WALL–MOUNTED THERMOSTAT AND ALL ASSOCIATED MOUNTING DEVICE AND WIRING. (1)
5. BOX TO REMAIN FOR TEMPORARY HEAT. REMOVE LOW PRESSURE DUCTWORK AS SHOWN AND ALLOW TO DISCHARGE DIRECTLY TO SPACE. RETAIN EXISTING THERMOSTATS FOR BOX CONTROL.

DEMOLITION NOTES:

1. THE CONTRACTOR SHALL REMOVE ONLY EXISTING HEATING, AIR CONDITIONING, VENTILATION EQUIPMENT AND MATERIALS INDICATED ON THIS DRAWING. ITEMS TO BE REMOVED SHALL INCLUDE EQUIPMENT AND ALL ASSOCIATED APPURTENANCES AS WELL AS GRILLS, REGISTERS, DIFFUSERS, DUCTS, HANGERS, SUPPORTS, WHERE APPLICABLE.
2. SALVAGEABLE ITEMS: ALL MIXING BOXES THAT ARE REMOVED SHALL REMAIN THE PROPERTY OF THE OWNER AND BE DELIVERED TO THE OWNERS WAREHOUSE LOCATED ON CAMPUS IN A LOCATION AS DIRECTED. ALL OTHER ITEMS SHALL BECOME THE PROPERTY OF THE CONTRACTOR. ITEMS OF SALVAGEABLE VALUE TO CONTRACTOR MAY BE REMOVED FROM STRUCTURE AS WORK PROGRESSES. CONTRACTOR– SALVAGED ITEMS MUST BE TRANSPORTED FROM SITE AS THEY ARE REMOVED.
3. EXISTING FLEXIBLE DUCT WORK MAY NOT BE RE–USED.
4. ALL VOIDS LEFT BY REMOVING EQUIPMENT PIPING, DUCTS AND LOUVERS SHALL BE FILLED WITH THE SAME MATERIALS AS THE WALLS, FLOORS, OR ROOF.
5. PATCH AND SEAL ALL REMAINING DUCT WORK AIR TIGHT, LINED AND/OR INSULATED TO MATCH EXISTING.

PRELIMINARY DRAWING DATE ISSUED 4-6-09
PRELIMINARY DRAWING DATE ISSUED 11-30-09
90% DRAWING DATE ISSUED 12-11-09
BID DRAWING DATE ISSUED: 1-08-10
PERMIT DRAWING DATE ISSUED:
CONSTRUCTION DRAWING DATE ISSUED:
AS-BUILT DRAWING DATE ISSUED:

CENTURY ENGINEERING
EASTERN PCM, LLC
PROGRAM AND CONSTRUCTION MANAGEMENT ... PUTTING THE PIECES TOGETHER
ARCHITECTURE, CREATING EXCEPTIONAL PLACES
2101 NORTH FRONT STREET
BUILDING #1, SUITE 100
HARRISBURG, PA 17110
717.236.2266 PHONE
717.236.1655 FAX

No.	Date	Revisions	By	Check
1	1/8/10	REVISED HVAC DEMO	KTN	CJ

Project Name
BLOCKER HALL - ALLIED HEALTH: CONTRACT NO. 1 - INTERIOR SELECTIVE DEMOLITION

Project # 0536

Description
PARTIAL FIRST FLOOR PLAN - DEMOLITION

Date DECEMBER 18, 2009

Scale AS NOTED

Key Plan

MD-101

Scale 0

All drawings and written material appearing herein constitute original and unpublished work of the architect and may not be duplicated, used or disclosed without the written consent of the architect.

PARTIAL FIRST FLOOR PLAN - DEMOLITION.dwg 1/8/2010 2:46 PM
plotted by: Kyle Hoss
DWG TO PDF.PC3

BLOCKER HALL - ALLIED HEALTH: CONTRACT NO. 1 - INTERIOR SELECTIVE DEMOLITION CEI # 093055